


LABOR AND MATERIALS

Copper	} Connection	_____	\$ _____	
Lead				
Curb	} Cock Valve } T. S. & V. }	_____ in.	\$ _____	
Service box		} Short 3½ x 4½ } Long 4½ x 5½ }	_____	\$ _____
Old returned			Buff or Rdway	_____
22 Ft. 3/4 in.	} Copper } G.I. } C.I. }	Pipe at	\$ _____	
Nipples		in. at	\$ _____	
Bushings		to _____ in. at	\$ _____	
Red'g } Inc'g }	} Coupl'gs	to _____ in. at	\$ _____	
Union		in. at	\$ _____	
Meter	in. at	\$ _____		
Lead Joints	at	\$ _____		
Compound Joints	at	\$ _____		
Maintenance Foreman		\$ _____		
Hrs. Water Maint. Man-1	at	\$ _____		
Hrs. Water Maint. Man-2	at	\$ _____		
Hrs. Garage Foreman	at	\$ _____		
Hrs. Labor	at	\$ _____		
Hrs. Compressor	at	\$ _____		
Compensation Ins. at \$ _____	per C	\$ _____		
Trucking		\$ _____		
Pav't Patch		\$ _____		
		\$ _____		
		\$ _____		
		\$ _____		
O'head		\$ _____		
		\$ _____		

Jones
 St. _____
 Pl. _____
 Ave. No. 7

Name of Owner
Red Swift

Labor and Mat'l. Report Dec 1987

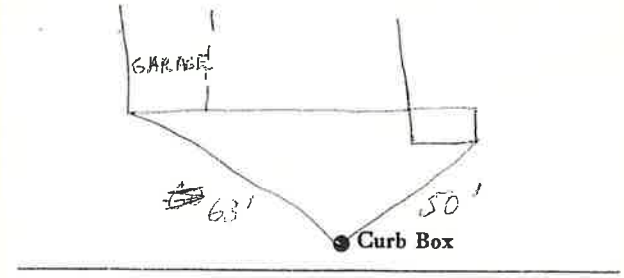

Main Elev. of
 Gate at ● Main at tap _____

● Curb Box