


LABOR AND MATERIALS

Copper	}	Connection			\$
Lead					
Curb	}	Cock	}	in.	\$
		Valve			
		T. S. & V.			
Service box	}	Short 3½ x 4½	}	}	\$
Old returned		Long 4½ x 5½			
15'9" Ft. ^{or} 22½'		3/4 in. { Copper } { G. I. } { G. I. }		Pipe at	\$
Nipples	in.	at			\$
Bushings	to	in.	at		\$
Red'g } Inc'g }	Coupl'gs	to	in.	at	\$
Union	in.	at			\$
Meter	in.	at			\$
Compound Joints	at				\$
Maintenance Foreman					\$
Hrs. Water Maint. Man	1	at			\$
Hrs. Water Maint. Man	2	at			\$
Hrs. Garage Foreman		at			\$
Hrs. Labor		at			\$
Hrs. Compressor		at			\$
Trucking					\$
Pav't Patch					\$
					\$
					\$
Lane
St.
Pl.
Ave. No. 9

Name of Owner
Kidder
Crisafulli

Labor and Mat'l. Report 1988

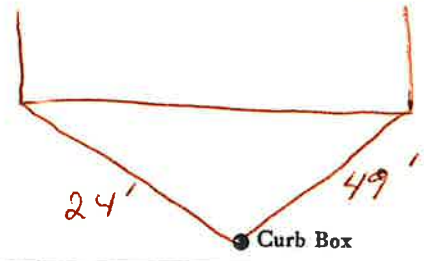

6" Main Elev. of Main at tap 5'

Gate at • • Gate at

• Curb Box