

LABOR AND MATERIALS

1	Copper	Connection	3/4"	\$	2.41		
1	Lead	Cock Valve	3/4" in.	\$	3.41		
		T. S. & V.					
1	Service box	Short 3 1/2 x 4 1/2 Long 4 1/2 x 5 1/2 Buff. or Rdway		\$	4.18		
	Old returned						
25	Ft.	Copper	3/4" in.	} Pipe at	40	\$	10.00
		C.I.					
	Nipples	in. at		\$			
	Bushings	to in. at		\$			
	Red'g	Coupl'gs	to in. at	\$			
	Inc'g						
	Union	in. at		\$			
	Meter	in. at		\$			
	Lead Joints	at		\$			
	Compound Joints	at		\$			
	Maintenance Foreman			\$			
	Hrs. Water Maint. Man-1	at		\$			
5	Hrs. Water Maint. Man-2	at 1.24		\$	6.20		
	Hrs. Garage Foreman	at		\$			
16	Hrs. Labor	at 1.13		\$	18.08		
	Hrs. Compressor	at		\$			
	Compensation Ins.	at \$ 396.1 per C		\$	94		
	Trucking			\$	1.50		
	Pav't Patch			\$	11.20		
	O'head			\$			
							\$ 57.92

Tap by 9-77-26-23-54

16-72

73-54


St. Pl. Ave. No. 2

Knight

Name of Owner

Carpenter

Labor and Mat'l. Report June 23 19 54

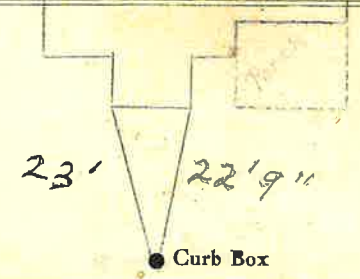

6" Main Elev. of Main at tap 5'

Gate at ● Gate at ●

● Curb Box

TAP ON SOUTH ST