


LABOR AND MATERIALS

1	Copper	Connection	3/4"	\$
1	Lead	Cock	Oriscat 3/4"	\$
1	Curb	Valve	1/2 in.	\$
		T.S. & V.		
1	Service box	Short 3 1/2 x 4 1/2		\$
	Old returned	Long 4 1/2 x 5 1/2		\$
		Buff or Rdway		\$
11	Ft. 3/4 in.	Copper	Pipe at	\$
		G.I.		\$
		G.I.		\$
	Nipples	in. at		\$
	Bushings	to in. at		\$
	Red'g			\$
	Inc'g	Coupl'gs. to in. at		\$
	Union	in. at		\$
	Meter	in. at		\$
	Lead Joints	at		\$
	Compound Joints	at		\$
	Maintenance Foreman			\$
	Hrs. Water Maint. Man-1	at		\$
	Hrs. Water Maint. Man-2	at		\$
	Hrs. Garage Foreman	at		\$
	Hrs. Labor	at		\$
	Hrs. Compressor	at		\$
	Compensation Ins. at \$	per C		\$
	Trucking			\$
	Pav't Patch			\$
	Top by Gilbert & Co.			\$
	July 9-64			\$
	O'head			\$
				\$

St. 12
 Ave. No. 12
 Name of Owner Knight
Wm R. Knight
 Labor and Mat'l. Report July 9 1964

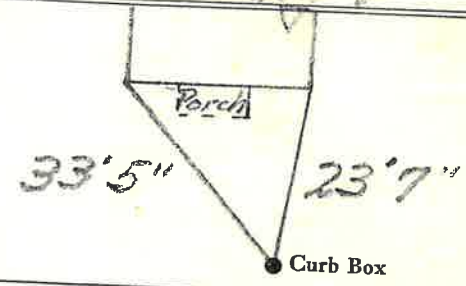

6" Main Elev. of Main at tap 5'
 Gate at ● Gate at ●
 ● Curb Box