


**Labor and Materials**

Lead Connection	5	at	\$
1 Curb Cock	3/4	at	\$
1 Service Box	{ Short 3 1/2 x 4 1/2 Long 4 1/2 x 5 1/2	at	\$
Old returned	Barrels		
28 Ft. 3/4 in. G. I. Pipe	at	\$	
Nipples	in. at	\$	
1 Bushing	3/4 to 1/2 in. at	\$	
Red'g Coup	to in. at	\$	
Inc'g Coup	to in. at	\$	
Union	in. at	\$	
Meter	in. at	\$	
Cu. Yds. Br. Stone	at	\$	
Cu. Yds. Sand	at	\$	
Bags Cement	at	\$	
Paving Brick	{ Mack Red Asphalt }	at	\$
2 3/4 Hrs. Foreman	at	\$	
18 Hrs. Common Labor	at	\$	
Hrs. Mason	at	\$	
1 1/2 Hrs. Baker	at	\$	
Hrs.	at	\$	
No Builders' Use of Water		\$	
Trook	at	\$	
	at	\$	
	at	\$	
	at	\$	
Total	\$	27.19	

139 Knight St.

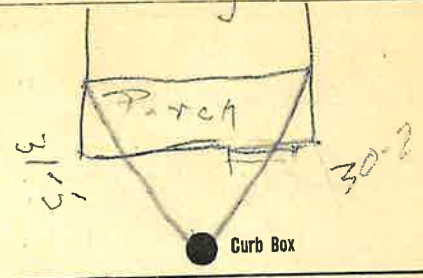

Main Elev. of Main at tap  
Gate at ● Gate at ●

