

LABOR AND MATERIALS

1	Copper Lead	Connection	$\frac{3}{4}$ "	\$
1	Curb	Cock Valve T.S. & V.	$\frac{3}{4}$ in.	\$
1	Service box	Short $3\frac{1}{2}$ x $4\frac{1}{2}$	} ?	\$
?	Old returned	Long $4\frac{1}{2}$ x $5\frac{1}{2}$		
28	Ft.	$\frac{3}{4}$ in.	Copper Pipe at	\$
			G.I.	
			G.I.	
	Nipples	in. at		\$
	Bushings	to in. at		\$
	Red'g			
	Inc'g	Coupl'gs to in. at		\$
	Union	in. at		\$
	Meter	in. at		\$
	Lead Joints	at		\$
	Compound Joints	at		\$
	Maintenance Foreman			\$
	Hrs. Water Maint. Man	1 at		\$
	Hrs. Water Maint. Man	2 at		\$
	Hrs. Garage Foreman	at		\$
	Hrs. Labor	at		\$
	Hrs. Compressor	at		\$
	Compensation Ins.	at \$ per C		\$
	Trucking			\$
	Pav't Patch			\$
	Measured by Giggard			\$
	Co. 4-6-59.			\$
	O'head			\$

Knight

St. 17
Ave. No. 17


Name of Owner

Dobert

Re-measured in Apr. 6-1959.

Labor and Mat'l. Report

19

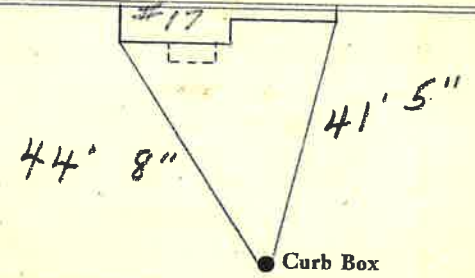

6" Main

Elev. of Main at tap 5'?

Gate at ●

● Gate at

● Curb Box