


cop Labor and Materials

Lead Connection	\$ 31.4	\$
1 Curb Cock	3/4	\$
1 Service Box (Short 3 1/2 x 4 1/2)		\$
Old returned		\$
8 Ft. 3/4 in. G.P. Pipe at		\$
1 Nipple 3/4 in. at		\$
Bushings	to in. at	\$
1 Red'g Coup 1" to 3/4 in. at		\$
Inc'g Coup	to in. at	\$
Union	in. at	\$
Meter	in. at	\$
Cu. Yds. Br. Stone at		\$
Cu. Yds. Sand at		\$
Bags Cement at		\$
Paving Brick { Mack Red Asphalt } at		\$
2 1/4 Hrs. Foreman at	6 2 1/2	\$
15 1/4 Hrs. Common Labor at	40 5/8	\$
Hrs. Mason at		\$
1 Hrs. Baker	50	\$
Hrs.	at	\$
No. Builders' Use of Water		\$
Truck		\$
		\$
		\$
		\$
		\$
Total	110.36	\$

Labor and Material Report Aug. 19 35

18 Knight St.

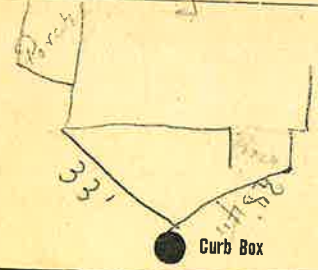

6" Main Elev. of Main at tap
 Gate at ● Gate at ●

