

LABOR AND MATERIALS

Copper	} Connection	_____	\$ _____
Lead			
Curb	} Cock Valve } T.S. & V. }	_____ in.	\$ _____
Service box	} Short 3½ x 4½ } Long 4½ x 5½ } Buff or Rdway }	_____	\$ _____
Old returned			
Ft. _____ in.	} Copper } G. I. } C. I. }	Pipe at _____	\$ _____
Nipples _____ in.	at _____	\$ _____	
Bushings _____ to _____ in.	at _____	\$ _____	
Red'g } Inc'g }	} Coupl'gs. _____ to _____ in.	at _____	\$ _____
Union _____ in.		at _____	\$ _____
Meter _____ in.	at _____	\$ _____	
Lead Joints	at _____	\$ _____	
Compound Joints	at _____	\$ _____	
Maintenance Foreman	_____	\$ _____	
Hrs. Water Maint. Man—1	at _____	\$ _____	
Hrs. Water Maint. Man—2	at _____	\$ _____	
Hrs. Garage Foreman	at _____	\$ _____	
Hrs. Labor—	at _____	\$ _____	
Hrs. Compressor	at _____	\$ _____	
Compensation Ins. at \$ _____	per C _____	\$ _____	
Trucking	_____	\$ _____	
Pav't Patch	_____	\$ _____	
_____	_____	\$ _____	
_____	_____	\$ _____	
_____	_____	\$ _____	
O'head	_____	\$ _____	
		\$ _____	

Lot Tap.

Knight


St. \_\_\_\_\_  
 Pl. \_\_\_\_\_  
 Ave. No. 19

Name of Owner

Remeasured in Apr. 6-1959.

Labor and Mat'l. Report

19

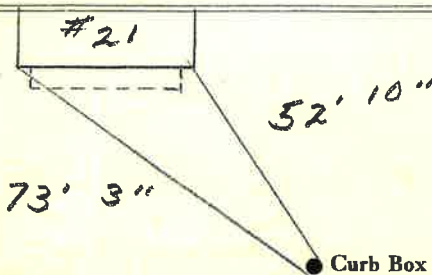

6" Main

Elev. of Main at tap 5'?

Gate at •

• Gate at

• Curb Box

Measured from #21