

LABOR AND MATERIALS

Copper	} Connection	_____	\$ _____	
Lead				
Curb	} Cock } Valve } T. S. & V.	_____ in.	\$ _____	
Service box		} Short 3½ x 4½ } Long 4½ x 5½		
Old returned				\$ _____
Ft. $\frac{3}{4}$ in.	} Copper } C.I. } C.I.	Pipe at _____	\$ _____	
Nipples		_____ in. at _____	\$ _____	
Bushings	_____ to _____ in. at _____	\$ _____		
Red'g } Inc'g }	} Coupl'gs	_____ to _____ in. at _____	\$ _____	
Union		_____ in. at _____	\$ _____	
Meter	_____ in. at _____	\$ _____		
Compound Joints	at _____	\$ _____		
Maintenance Foreman		\$ _____		
Hrs. Water Maint. Man-1	at _____	\$ _____		
Hrs. Water Maint. Man-2	at _____	\$ _____		
Hrs. Garage Foreman	at _____	\$ _____		
Hrs. Labor	at _____	\$ _____		
Hrs. Compressor	at _____	\$ _____		
Trucking		\$ _____		
Pav't Patch		\$ _____		
		\$ _____		
		\$ _____		
		\$ _____		
		\$ _____		


KNIGHT

St. ~~Pl.~~
Ave. No. 20

Name of Owner _____

Labor and Mat'l. Report

1994

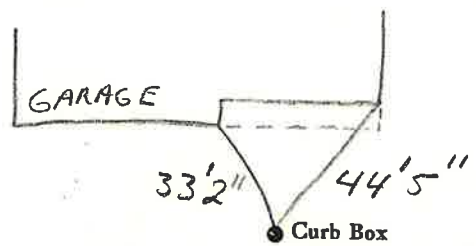

Main _____ Elev. of Main at tap _____
Gate at • _____ Gate at _____

• Curb Box