


Labor and Materials

Lead Connection	\$
1 Curb Cock	\$
1 Service Box	\$
Old returned	\$
6 Ft. 3/4 in. C. Pipe at	\$
Nipples in. at	\$
Bushings to in. at	\$
Red'g Coup to in. at	\$
Ine'g Coup to in. at	\$
Union in. at	\$
Meter in. at	\$
Cu. Yds. Br. Stone at	\$
Cu. Yds. Sand at	\$
Bags Cement at	\$
Paving Brick { Mack } at	\$
Red. Asphalt	\$
Hrs. Foreman at	\$
Hrs. Common Labor at	\$
Hrs. Mason at	\$
Hrs. <i>Baker</i> at	\$
Hrs. at	\$
Builders' Use of Water	\$ 1.00
Total	\$

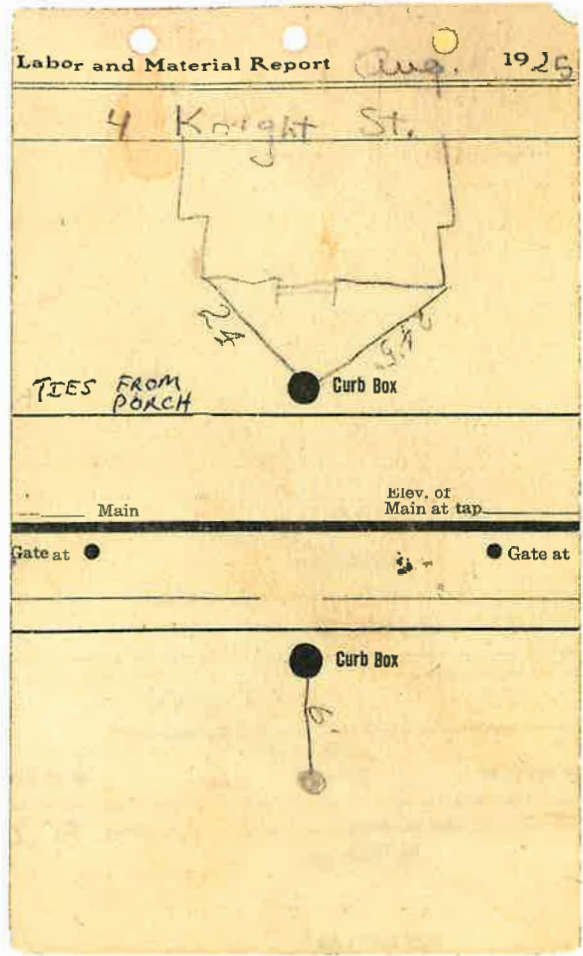

24'

24' 5"