


Labor and Materials

1	Cap Connection	3/4		\$
1	Curb Cock	3/4		\$
1	Service Box	(Sheet Metal)		\$
	Old returned	Long 4 1/2 x 6 1/2		\$
12	Ft. in C.I. Pipe at	3/4		\$
	Nipples	in. at		\$
	Bushings	to in. at		\$
	Red'g Coup	to in. at		\$
	Inc'g Coup	to in. at		\$
	Union	in. at		\$
	Meter	in. at		\$
	Cu. Yds. Br. Stone at			\$
	Cu. Yds. Sand at			\$
	Bags Cement at			\$
	Paving Brick	{ Mack Red Asphalt }	at	\$
2 1/4	Hrs. Foreman at			\$
11	Hrs. Common Labor at			\$
	Hrs. Mason at			\$
1	Hrs.	Baker	at	\$
	Hrs.		at	\$
No	Builders' Use of Water			\$
	Truck		at	\$
			at	\$
			at	\$
			at	\$
			at	\$
	Total			\$ 14.68

Labor and Material Report

22 Knight Street

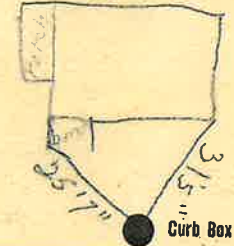

Main _____ Elev. of Main at tap _____
 Gate at ● _____ Gate at ● _____

