


LABOR AND MATERIALS

1 Copper } Connection 3/4" \$
 Lead }
 1 Curb } Cock }
 Valve } 3/4" in. \$
 T.S. & V. }
 1 Service box } Short $3\frac{1}{2} \times 4\frac{1}{2}$ }
 Old returned } Long $4\frac{1}{2} \times 5\frac{1}{2}$ }
 Buff or Rdway } \$
 25 Same }
 Ft. 3/4" in. } { Copper } Pipe at \$
 { G.I. }
 { C.I. }
 Nipples _____ in. at \$
 Bushings _____ to _____ in. at \$
 Red'g }
 Inc'g } Coupl'gs _____ to _____ in. at \$
 Union _____ in. at \$
 Meter _____ in. at \$
 Lead Joints at \$
 Compound Joints at \$
 Maintenance Foreman \$
 Hrs. Water Maint. Man-1 at \$
 Hrs. Water Maint. Man-2 at \$
 Hrs. Garage Foreman _____ at \$
 Hrs. Labor _____ at \$
 Hrs. Compressor at \$
 Compensation Ins. at \$ _____ per C \$
 Trucking \$
 Pav't Patch \$
 Tap by Gissord & \$
Co. 6-20-62 \$
 O'head _____ \$
 _____ \$

Knight St. Ave. No. 29
 -Pl-
 -Ave. No. 29

Name of Owner Bailey

Labor and Mat'l. Report June 20 1962

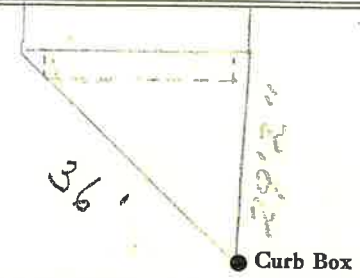

6" Main Elev. of Main at tap 5 1/2'
 Gate at • Gate at

• Curb Box