

LABOR AND MATERIALS

Copper	} Connection		\$
Lead			\$
Curb	} Cock Valve	in.	\$
Service box	} Short 3½ X 4½ Long 4½ X 5½		\$
Old returned		Buffer Rdway	
14 Ft.	} Copper G. I. C. I.	} Pipe at	\$
in.			
Nipples	in.	at	\$
Bushings	to	in.	at
Red'g			\$
Inc'g	} Coupl'gs	to	in.
Union	in.	at	\$
Meter	in.	at	\$
Lead Joints	at		\$
Compound Joints	at		\$
Hrs. Water Maint. Man—1	at		\$
Hrs. Water Maint. Man—2	at		\$
Hrs. Labor—	at		\$
Hrs. Labor—	at		\$
Hrs. Compressor	at		\$
Compensation Ins.	at \$	per C	\$
Trucking			\$
Pav't Patch			\$
O'head			\$
			\$
			\$
St. _____
 Ave. No. 32


Knight

Name of Owner _____

Martel

Measured IN 11-19-52

Labor and Mat'l. Report Tap before 1925

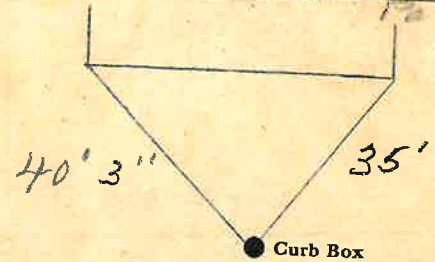

6" Main Elev. of Main at tap 5'

Gate at ● ● Gate at

● Curb Box