

### LABOR AND MATERIALS

Copper	Lead	Connection		\$	
	}	Cock	in.	\$	
Curb		Valve			
		T. S. & V.			
Service box	}	Short 3½ x 4½		\$	
Old returned		Long 4½ x 5½			
		Buff or Rdway			
24 Ft. ¾" in.	}	Copper	Pipe at	\$	
		G. I.			
		C. I.			
Nipples	in.	at		\$	
Bushings	to	in.	at	\$	
Red'g	}	Coupl'gs	to	in.	at
Ino'g					
Union	in.	at		\$	
Meter	in.	at		\$	
Lead Joints	at			\$	
Compound Joints	at			\$	
Maintenance Foreman				\$	
Hrs. Water Maint. Man	1	at		\$	
Hrs. Water Maint. Man	2	at		\$	
Hrs. Garage Foreman		at		\$	
Hrs. Labor		at		\$	
Hrs. Compressor	at			\$	
Compensation Ins.	at \$	per C.		\$	
Trucking				\$	
Pav't Patch				\$	
				\$	
				\$	
				\$	
O'head				\$	
				\$	

KNIGHT

St.  
Pr. 33  
Ave. No.


Name of Owner

CAVANOUGH

MEASUREMENTS TAKEN FROM #31

Labor and Mat'l. Report 3-30 1978

LINE TO 33  
KNIGHT

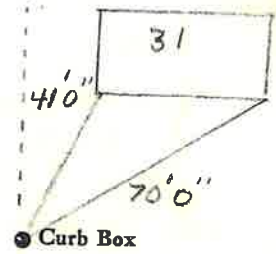

6" Main

Elev. of  
Main at tap

Gate at ●

● Gate at

● Curb Box