


LABOR AND MATERIALS

_____	Copper } Connection _____	\$ _____
_____	Lead } _____	\$ _____
_____	Curb } Cock } _____ in.	\$ _____
_____	_____ } Valve } _____	\$ _____
_____	_____ } T.S. & V. } _____	\$ _____
_____	Service box { Short 3-1/2 x 4-1/2 }	\$ _____
_____	Old returned { Long 4-1/2 x 5-1/2 }	\$ _____
13'6"	Ft. 3/4" in. Copper Pipe at _____	\$ _____
_____	Nipples _____ in. at _____	\$ _____
_____	Bushings _____ to _____ in. at _____	\$ _____
_____	Red'g _____	\$ _____
_____	Inc'g _____	\$ _____
_____	Union _____ in. at _____	\$ _____
_____	Meter _____ in. at _____	\$ _____
_____	_____	\$ _____
_____	Compound Joints at _____	\$ _____
_____	Maintenance Foreman _____	\$ _____
_____	Hrs. Water Maint. Man - 1 at _____	\$ _____
_____	Hrs. Water Maint. Man - 2 at _____	\$ _____
_____	Hrs. Garage Foreman _____ at _____	\$ _____
_____	Hrs. Labor _____ at _____	\$ _____
_____	Hrs. Compressor at _____	\$ _____
_____	_____	\$ _____
_____	Trucking _____	\$ _____
_____	Pav't Patch _____	\$ _____
_____	_____	\$ _____
_____	_____	\$ _____
_____	_____	\$ _____
_____	_____	\$ _____

KNIGHT St. Pt. Ave. No. **35**

Name of Owner **JOSEPH DILANDRO**

Labor and Mat'l. Report ~~to~~ **5/7/2004**

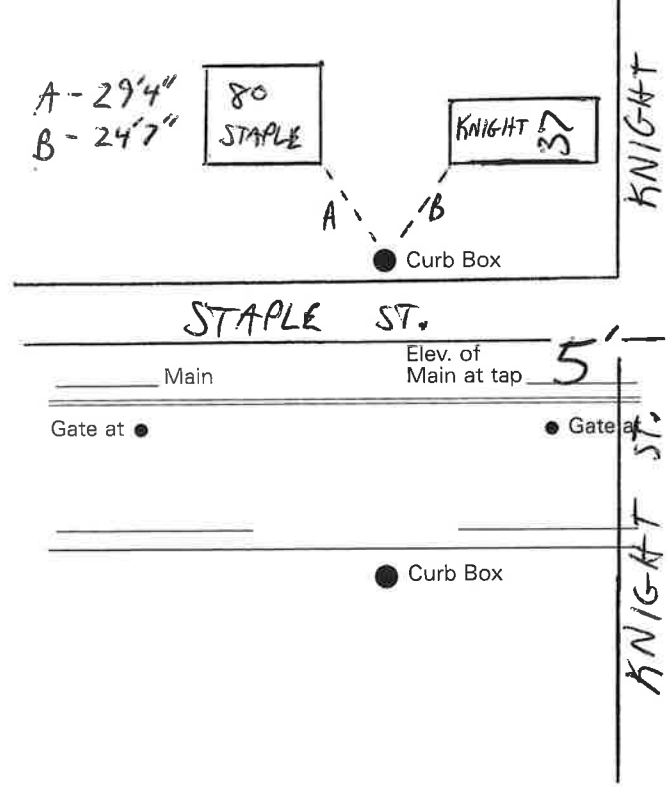

LABOR AND MATERIALS

Copper	}	Connection			\$	
Lead						
Curb	}	Cock Valve T. S. & V.		in.	\$	
Service Box			}	Short 3/2x4 1/2		\$
Old returned				Long 4 1/2x5 1/2 Buff. or Rdway		
Ft.	}	}		in.	\$	
		Copper Galv Iron Cast Iron	Pipe at			
Nipples			in. at		\$	
Bushings			to in. at		\$	
Red'g Inc'g	}	Couplings	to	in. at	\$	
Union				in. at		\$
Meter			in. at		\$	
Lead Joints			at		\$	
Leadite Joints			at		\$	
Hrs. Foreman			at		\$	
Hrs. Chauffeur			at		\$	
Hrs. Tapper			at		\$	
Hrs. Labor			at		\$	
Hrs. Labor			at		\$	
Hrs. Compressor			at		\$	
Compensation Ins.					\$	
Trucking					\$	
Builders Use of Water					\$	
					\$	
					\$	
					\$	
					\$	


St.
Pt.
Ave. No. 35

Knight

Name of Owner

Labor and Mat'l. Report

19

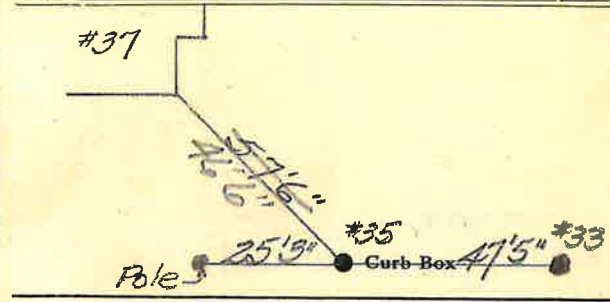

Main Elev. of
Main at tap

Gate at ● ● Gate at

● Curb Box