


LABOR AND MATERIALS

1	Copper	} Connection	3/4"	\$		
1	Lead					
1	Curb	} Cock Valve T.S. & V.	3/4 in.	\$		
1	Service box					
Old returned	Short 3 1/2 x 4 1/2 Long 4 1/2 x 5 1/2 Buff or Rdway					
?	Ft. 3/4 in.	} Copper G.I. G.I.	} Pipe at	\$		
	Nipples				in. at	\$
	Bushings				to in. at	\$
	Red'g } Inc'g }	} Coupl'gs	to in. at	\$		
	Union				in. at	\$
	Meter	in. at	\$			
	Lead Joints	at	\$			
	Compound Joints	at	\$			
	Maintenance Foreman		\$			
	Hrs. Water Maint. Man-1	at	\$			
	Hrs. Water Maint. Man-2	at	\$			
	Hrs. Garage Foreman	at	\$			
	Hrs. Labor-	at	\$			
	Hrs. Compressor	at	\$			
	Compensation Ins. at \$	per C	\$			
	Trucking		\$			
	Pav't Patch		\$			
	Measured in		\$			
	Apr. 10 - 69		\$			
	O'head		\$			
			\$			

*Knight* St. Pl. Ave. No. 36

Name of Owner

Measured in Labor and Mat'l. Report Apr. 10 19 69

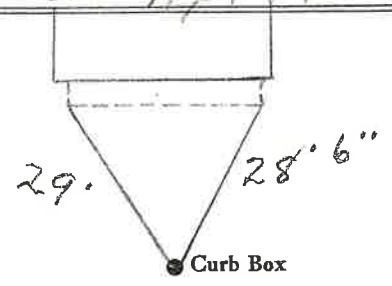

4' or 6" Main Elev. of Main at tap 5'

Gate at • • Gate at

• Curb Box