


Labor and Materials

Copper } Connection.....	3	\$ 2.70
Lead }		
Curb } Cock Valve }	3	\$ 2.39
} T.S. & V. }		
Service Box } (Short 3 1/2 x 4 1/2 }		\$ 1.45
Old returned } (Long 4 1/2 x 5 1/2 }		
} Buff. or Rdway }		
25 Ft. } Copper }	3	\$ 6.75
} Galv. Iron } Pipe at		
} Cast Iron }		
Nipples..... in. at.....	4	\$
Bushings..... to..... in. at.....		\$
Red'g } Couplings..... to..... in. at.....		\$
Inc'g }		
Union..... in. at.....		\$
Meter..... in. at.....		\$
Lbs. Br. Stone at.....		\$
Lbs. Sand at.....		\$
Bags Cement at.....		\$
Paving Brick } Mack } at.....		\$
} Red }		
} Asphalt }		
Lead Joints at.....		\$
Leadite Joints at.....		\$
2 Hrs. Foreman at.....		\$ 1.25
5 Hrs. Common Labor at.....	Tapper at	\$ 2.50
8 Hrs. Common Labor at.....		\$ 3.60
Hrs. Mason at.....		\$
Hrs. Mason's Helper at.....		\$
Hrs. Compressor at.....		\$
Compensation Ins.....		\$ 29
Trucking.....		\$ 1.-
Builders' Use of Water.....	Patch	\$ 5.-
Total \$.		76.93

Labor and Material Report

Nov. 7 1930

42 Knight St.

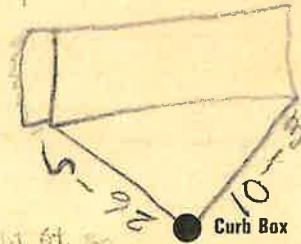

Tap on Knight St. as measured in.

4 Main

Elev of Main at tap 5

Gate at ●

● Gate at

● Curb Box