


### Labor and Materials

Copper } Connection.....	3	\$ 3.20
Lead } .....	46	
Curb } Cock Valve } .....	1	\$ 1.00
} T.S. & V. } .....	4	
Service Box } Short 3 1/2 x 4 1/2 } .....		\$ 1.30
Old returned } Bone 4 1/2 x 5 1/2 } .....		
} Bolt or Rdway } .....		
Pt.....in. } Copper } Pipe at.....	3	\$ 2.20
} Galv. Iron } .....		
} Cast Iron } .....	3	
Nipples.....in. at.....		\$
Bushings.....to.....in. at.....		\$
Red'g } Couplings.....to.....in. at.....		\$
Inc'g } .....		\$
Union.....in. at.....		\$
Meter.....in. at.....		\$
Lbs. Br. Stone at.....		\$
Lbs. Sand at.....		\$
Bags Cement at.....		\$
Paving Brick } Mack } at.....		\$
} Red } .....		
} Asphalt } .....		
Lead Joints at.....		\$
Leadite Joints at.....		\$
3 Hrs. Foreman at.....		\$ 1.88
15 Hrs. Common Labor at.....		\$ 6.09
Hrs. Common Labor at.....		\$
Hrs. Mason at.....		\$
Hrs. Mason's Helper at.....		\$
Hrs. Compressor at.....		\$
Compensation Ins.....		\$ 2.1
Trucking.....		\$ 1.00
Builders' Use of Water.....		\$
Total \$.		16.88.

### Labor and Material Report

Dec 28 1928

3/49 Knight St.

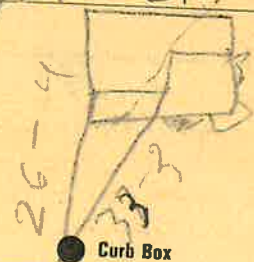

12" 1971

5 1/2'

Main Eley of Main at tap  
 Gate at 8' to main Gate at

Curb Box

Old tap about 1880