

LABOR AND MATERIALS

1	Copper Lead	{ Connection	3/4"		\$ 2.29
1	Curb	{ Cock Valve T.S. & V.	3/4" in.		\$ 2.70
1	Service box	{ Short 3 1/2 x 4 1/2 Long 4 1/2 x 5 1/2 Buff or Rdway			\$ 4.25
10	Old returned				
11	Ft.	{ Copper G.I. C.I.	3/4 in.	Pipe at 35	\$ 3.85
	Nipples	in. at			\$
	Bushings	to in. at			\$
	Red'g Inc'g	{ Coupl'gs to in. at			\$
	Union	in. at			\$
	Meter	in. at			\$
	Lead Joints at				\$
	Compound Joints at				\$
	Hrs. Water Maint. Man-1	at			\$
3	Hrs. Water Maint. Man-2	at	1.02		\$ 3.06
12	Hrs. Labor	at	91		\$ 10.92
	Hrs. Labor	at			\$
1	Hrs. Compressor at		1.20		\$ 1.20
	Compensation Ins. at \$ 2.526 per C.				\$ 31
	Trucking				\$ 1.00
	Pav't Patch				\$ 2.10
	Tap by Gifford				\$
	O'head				\$
					\$ 37.68


166-1750

St.
PF
Ave. No. 51

Knight

Name of Owner Guyette

Labor and Mat'l. Report Sept 13 19 50

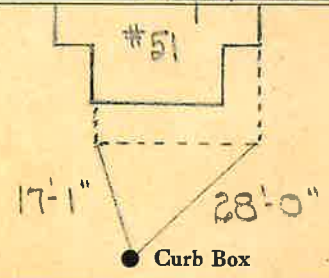

12"-1971
Main Elev. of Main at tap 5'

Gate at ● Gate at ●
10' to main

● Curb Box