

LABOR AND MATERIALS


1	Copper Lead	Connection	3/4	\$	1.35
1	Curb	Cock Valve T. S. & V.	3/4 in.	\$	1.88
1	Service Box	Short 3 1/2 x 4 1/2		\$	1.87
	Old returned	Long 4 1/2 x 5 1/2		\$	
		Buff for Rdway		\$	
10	Ft.	3/4 in.	Copper Galv Iron Cast Iron	Pipe at	20 \$ 2.00
	Nipples	in. at		\$	
	Bushings	to in. at		\$	
	Red'g Inc'g	Couplings	to in. at	\$	
	Union	in. at		\$	
	Meter	in. at		\$	
	Lead Joints	at		\$	
	Leadite Joints	at		\$	
	Hrs. Foreman	at		\$	
	Hrs. Chauffeur	at		\$	
	Hrs. Tapper	at		\$	
	Hrs. Labor	at		\$	
	Hrs. Labor	at		\$	
	Hrs. Compressor	at		\$	
	Compensation Ins.			\$	
	Trucking			\$	
	Builders Use of Water			\$	
	Tap by <i>W. Marsinski</i>			\$	
				\$	
				\$	
				\$	
				\$	

43-42

St. Knight
Pl. Ave. No. 53

Name of Owner Wood

Labor and Mat'l. Report Oct 29 1942

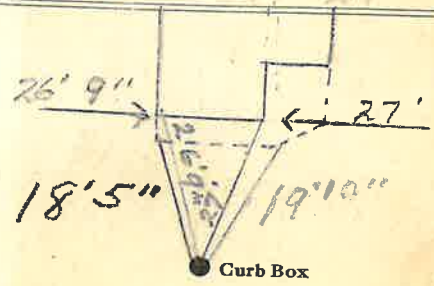

12"-1971

Main Elev. of Main at tap 5'

Gate at ● Gate at ●

● Curb Box