


Labor and Materials

1	Copper } Connection	3/4"	\$ 3.20
	Lead		
1	Curb } Cock Valve	3/4" in.	\$ 1.00
		P.S. & V.	
1	Service Box	Short 3 1/2 x 4 1/2	\$ 1.30
20	Old returned	Long 4 1/2 x 5 1/2	
		Buff. or Rdway	
27	Ft. 3/4 in.	Copper Galv. Iron	\$ 4.62
		Pipe at	
	Nipples	in. at	\$
	Bushings	to in. at	\$
1	Reg. In. } Couplings	to in. at	\$ 1.8
	Union	in. at	\$
	Meter	in. at	\$
	Lbs. Br. Stone	at	\$
	Lbs. Sand	at	\$
	Bags Cement	at	\$
	Paving Brick	{ Mack Red Asphalt } at	\$
	Lead Joints	at	\$
	Leadite Joints	at	\$
5	Hrs. Foreman	6 1/2	\$ 3.13
3	Hrs. Common Labor	50	\$ 1.50
	Hrs. Common Labor	at	\$
	Hrs. Mason	at	\$
	Hrs. Mason's Helper	at	\$
	Hrs. Compressor	at	\$
	Compensation Ins.		\$ 1.12
	Trucking		\$ 1.00
	Builders' Use of Water		\$
Total			\$ 16.05

27-174

Labor and Material Report *Sept 28* 19 *27*

3/4" tap at 56' Knight st

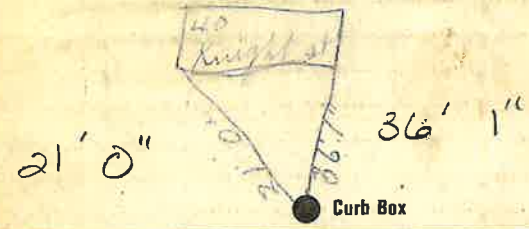

12"-1971

4" Main Elev. of Main at tap *5'*

Gate at ● Gate at ●

● Curb Box

New tap