

LABOR AND MATERIALS

1	Copper Lead	Connection	3/4	\$	1.79
1	Curb	Clock Valve 1-3- & v.	3/4 in.	\$	2.61
1	Service box	Short 3" X 4 1/2"		\$	
	Old returned	Long 4" X 5 1/2" Buff or Rdway		\$	1.82
2	Ft.	3/4 in.	Copper Galv. Iron Cast Iron	Pipe at	23 2.07
	Nipples	in. at		\$	
	Bushings	to in. at		\$	
	Red'g Inc'g	Couplings	to in. at	\$	
	Union	in. at		\$	
	Meter	in. at		\$	
	Lead Joints	at		\$	
	Compound Joints	at		\$	
7	Hrs. Foreman at	WUM	.84	\$	5.88
7	Hrs. Chauffeur at		.75	\$	5.25
	Hrs. Tapper at			\$	
	Hrs. Labor at			\$	
	Hrs. Labor at			\$	
	Hrs. Compressor at			\$	
	Compensation Ins.			\$	.31
	Trucking			\$	1.00
	Builders Use of Water			\$	5.00
	Taps by Miller & Brosinski			\$	
				\$	
				\$	
				\$	25.73

5-46

St. Knight	St. PI-
	Ave. No. 57
Name of Owner	
Boss	
Labor and Mat'l. Report	Mar 19 1946

See Below

1946  
See Below  
25'4" 27'5"  
Curb Box

12" - 1971  
Main

Elev. of Main at top 5

Gate at ● Gate at ●

10' to main


Curb Box

32' 19'2"

1261  
4-12-  
LBM-5C-6-1-45


4-12-

1971

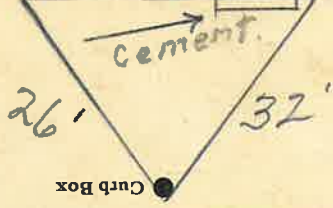

Gate at ● Gate at ●  
 10' to main  
 Elev. of Main at top 5  
 Main

12-1971

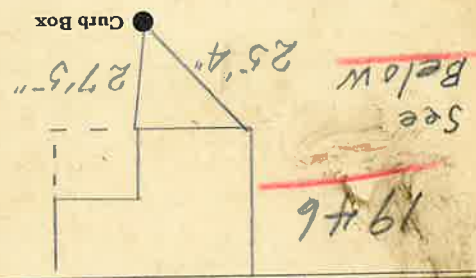

See Below

1946

Labor and Mat'l. Report Mar 19 1946

BOSS

Name of Owner

Knight

St. Pt. Ave. No.

5-7

5-1-46