


LABOR AND MATERIALS

1 Copper } Connection $\frac{3}{4}$ " \$
 1 Lead }
 1 Curb } Cock } $\frac{3}{4}$ " Oriseat \$
 } Valve }
 } T.S. & V. }
 1 Service box { Short $3\frac{1}{2}$ x $4\frac{1}{2}$ }
 Old returned { Long $4\frac{1}{2}$ x $5\frac{1}{2}$ }
 { Buff or Rdway } \$
 25 Ft. $\frac{3}{4}$ in. { Copper } Pipe at \$
 { G.I. }
 { C.I. }
 Nipples in. at \$
 Bushings to in. at \$
 Red'g }
 Inc'g } Coupl'gs. to in. at \$
 Union in. at \$
 Meter in. at \$
 Lead Joints at \$
 Compound Joints at \$
 Maintenance Foreman \$
 Hrs. Water Maint. Man-1 at \$
 Hrs. Water Maint. Man-2 at \$
 Hrs. Garage Foreman at \$
 Hrs. Labor at \$
 Hrs. Compressor at \$
 Compensation Ins. at \$ per C \$
 Trucking \$
 Pav't Patch \$
 Tap by Lareau & Co. \$
 4-12-71 \$
 O'head \$

Knight St. Ave. No. 58

Name of Owner Bonam.

Labor and Mat'l. Report Apr. 12 19 71

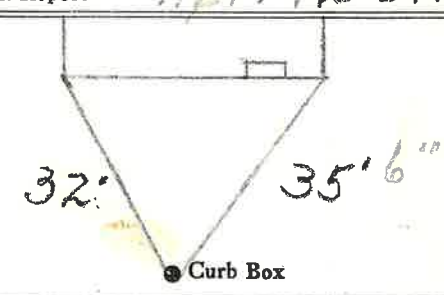

Main Elev. of Main at tap 5'

Gate at • Gate at •

• Curb Box