

LABOR AND MATERIALS

Copper	Lead	Connection		\$	
	}	Cock	in.	\$	
Curb		Valve			
		T. S. & V.			
Service box	}	Short 3½ x 4½		\$	
Old returned		Long 4½ x 5½			
		Buff or Rdway			
25 Ft.	¾ in.	Copper	} Pipe at	\$	
		G.I.			
Nipples	in. at			\$	
Bushings	to	in. at		\$	
Red'g	}	Coupl'gs	to	in. at	\$
Inc'g					
Union	in. at			\$	
Meter	in. at			\$	
Lead Joints	at			\$	
Compound Joints	at			\$	
Maintenance Foreman				\$	
Hrs. Water Maint. Man-1	at			\$	
Hrs. Water Maint. Man-2	at			\$	
Hrs. Garage Foreman	at			\$	
Hrs. Labor	at			\$	
Hrs. Compressor	at			\$	
Compensation Ins.	at \$	per C		\$	
Trucking				\$	
Pav't Patch				\$	
				\$	
				\$	
				\$	
O'head				\$	
				\$	


St.
Pl.
Ave. No. 60

Name of Owner

GEORGE COON

Labor and Mat'l. Report

19

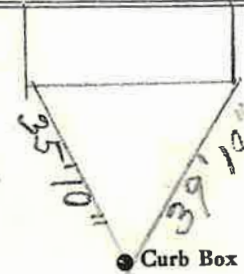

4 Main

Elev. of
Main at tap 4 1/2

Gate at ●

● Gate at

TAX ID # 309.15-4-19

● Curb Box