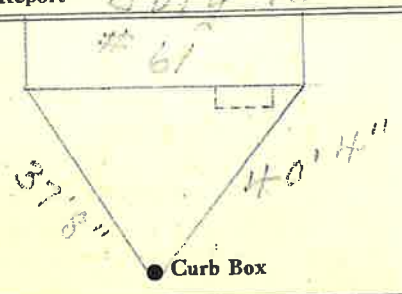


LABOR AND MATERIALS

1 Copper } Connection $\frac{3}{4}$ " \$ _____
 -Lead }
 1 Curb } Cock } $\frac{3}{4}$ in. \$ _____
 } Valve }
 } T.S. & V. }
 1 Service box { Short $3\frac{1}{2}$ x $4\frac{1}{2}$ }
 -Old returned { Long $4\frac{1}{2}$ x $5\frac{1}{2}$ }
 } Buff. or Rdway } \$ _____
 $\frac{9}{8}$ Ft. $\frac{3}{4}$ in. { Copper } Pipe at. \$ _____
 } G.I. }
 } C.I. }
 Nipples in. at \$ _____
 Bushings to in. at \$ _____
 1 Red'g } Coupl'gs 3 pc to $\frac{3}{4}$ " in. at \$ _____
 -Inc'g }
 Union in. at \$ _____
 Meter in. at \$ _____
 Lead Joints at \$ _____
 Compound Joints at \$ _____
 Maintenance Foreman \$ _____
 Hrs. Water Maint. Man-1 at \$ _____
 Hrs. Water Maint. Man-2 at \$ _____
 Hrs. Garage Foreman at \$ _____
 Hrs. Labor at \$ _____
 Hrs. Compressor at \$ _____
 Compensation Ins. at \$ _____ per C \$ _____
 Trucking \$ _____
 Pav't Patch \$ _____
 Tap by Gizzard & \$ _____
 Falby 7-15-58 \$ _____
 O'head \$ _____
 \$ _____
 \$ _____

✓
 St. _____
 -Pl. _____
 Ave. No. 61
 Name of Owner
Kenneth Carpenter
 Labor and Mat'l. Report July 15 1958


12" 1971
 Main
 Elev. of Main at tap 5'
 Gate at • Gate at
9' to main
 • Curb Box
 • Curb Box

LSM-5C-2-5 56