


LABOR AND MATERIALS

1	Copper Lead	Connection	3/4"	\$
1	Curb	Clock Valve T. S. & V.	3/4" in.	\$
1	Service box Old returned	Short 3 1/2 X 4 1/2 Long 4 1/2 X 5 1/2 Buffer Rdway		\$
24	Ft.	3/4" in.	Copper Galv. Iron Cast Iron	Pipe at \$
	Nipples	in. at		\$
	Bushings	to in. at		\$
	Red'g Inc'g	Couplings	to in. at	\$
	Union	in. at		\$
	Meter	in. at		\$
	Lead Joints at			\$
	Compound Joints at			\$
	Hrs. Foreman at			\$
	Hrs. Chauffeur at			\$
	Hrs. Tapper at			\$
	Hrs. Labor at			\$
	Hrs. Labor at			\$
	Hrs. Compressor at			\$
	Compensation Ins.			\$
	Trucking			\$
	Builders Use of Water			\$
	Maneuver by Miller Burgess			\$
				\$
				\$
				\$
				\$

Knight St. Pt. Ave. No. *64*

Name of Owner *Bumps*
 Found Copper *9-16-71*
 Labor and Mat'l. Report *Aug 27 1945*

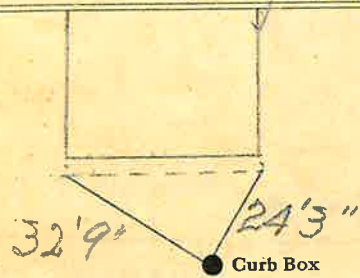

12" 1971 Main Elev. of Main at tap *5'*

Gate at ● Gate at ●

● Curb Box