

LABOR AND MATERIALS

1	Copper	} Connection	3/4"	\$
1	Lead			
1	Curb	} Cock Valve T.S. & V.	3/4 in. Or seat	\$
1	Service box			
Old returned	{ Short 3 1/2 x 4 1/2 Long 4 1/2 x 5 1/2 Buff or Rdway }			
? 3/4	Ft. in.	{ Copper G.I. C.I. }	Pipe at	\$
	Nipples	in. at		\$
	Bushings	to in. at		\$
	Red'g Inc'g	} Coupl'gs	to in. at	\$
	Union		in. at	\$
	Meter	in. at	\$	
	Lead Joints	at	\$	
	Compound Joints	at	\$	
	Maintenance Foreman		\$	
	Hrs. Water Maint. Man	—1 at	\$	
	Hrs. Water Maint. Man	—2 at	\$	
	Hrs. Garage Foreman	at	\$	
	Hrs. Labor	at	\$	
	Hrs. Compressor	at	\$	
	Compensation Ins.	at \$ per C	\$	
	Trucking		\$	
	Pav't Patch		\$	
	Tap by Peck & Co.		\$	
	9-16-71.		\$	
	O'head		\$	

Note:- Corp stop
1' West of curb box
Looking at House


Knierit St. Pl. Ave. No. 65

Name of Owner

Joseph Pepe.

Labor and Mat'l. Report

Sept. 16 19 71

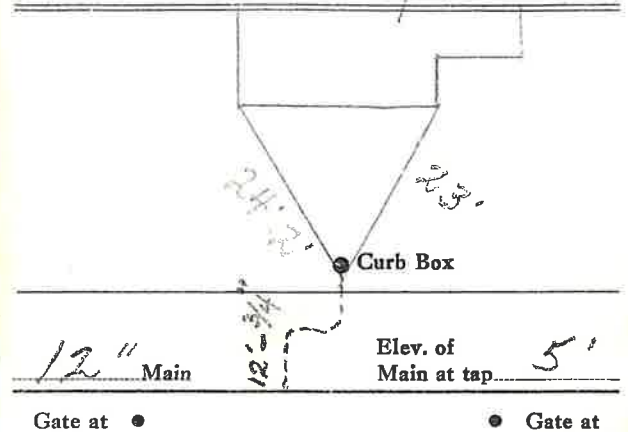

● Curb Box