

LABOR AND MATERIALS


1	Copper	} Connection	$\frac{3}{4}$ "	\$	
	Lead				
1	Curb	} Cock	$\frac{3}{4}$ in. oriseal	\$	
					} Valve
1	Service box	} { Short $3\frac{1}{2}$ x $4\frac{1}{2}$	}	\$	
	Old returned				} Long $4\frac{1}{2}$ x $5\frac{1}{2}$
10	Ft. $\frac{3}{4}$ in.	} { Copper	} Pipe at	\$	
					} G. I.
	Nipples	in. at	\$		
	Bushings	to in. at	\$		
	Red'g } Inc'g }	Coupl'gs to in. at	\$		
	Union	in. at	\$		
	Meter	in. at	\$		
	Lead Joints at		\$		
	Compound Joints at		\$		
	Maintenance Foreman		\$		
	Hrs. Water Maint. Man-1 at		\$		
	Hrs. Water Maint. Man-2 at		\$		
	Hrs. Garage Foreman at		\$		
	Hrs. Labor at		\$		
	Hrs. Compressor at		\$		
	Compensation Ins. at \$	per C	\$		
	Trucking		\$		
	Pav't Patch		\$		
	Tap by Lareau & Co		\$		
	8-26-71		\$		
	O'head		\$		

St. Pl. Ave. No. 69

*Night*

Name of Owner *Ernest A. Hanson*

Labor and Mat'l. Report *Aug. 26 1971*

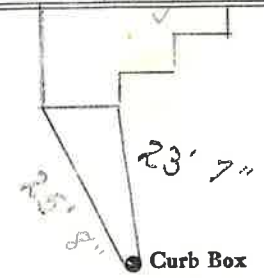

12" Main Elev. of Main at tap 5 1/2"

Gate at • Gate at

• Curb Box