


Labor and Materials

.....Copper } Connection.....	3	\$ 1.25
.....Lead }	4	
.....Curb { Cock }		
.....Curb { Valve }		
.....Curb { T.S.&V. }	3	\$ 1.70
.....Service Box { Short 3 1/2 x 4 1/2 }		
.....Old returned { Long 4 1/2 x 5 1/2 }		\$ 1.37
..... { Buff. or Rdway }		
.....10' Ft. 3/4 in. { Copper } Pipe at 13 1/2¢		\$ 1.08
..... { Galv. Iron }		
..... { Cast Iron }		
.....Nipplesin. at		\$
.....Bushingstoin. at.....		\$
.....Red'g } Couplings.....to.....in.at.....		\$
.....Inc'g }		
.....Union.....in. at		\$
.....Meter.....in. at		\$
.....Lbs. Br. Stone at		\$
.....Lbs. Sand at		\$
.....Bags Cement at		\$
.....Paving Brick { Mack } at		\$
..... { Red }		
..... { Asphalt }		
.....Lead Joints at		\$
.....Leadite Joints at		\$
.....3 Hrs. Foreman at 6 1/2 hr.		\$ 1.88
.....8 Hrs. Common Labor at 45		\$ 3.60
.....Hrs. Common Labor at		\$
.....Hrs. Mason at		\$
.....Hrs. Masons Helper at		\$
.....Hrs. Compressor at		\$
.....Compensation Ins		\$ 21
.....Trucking		\$ 1-
.....Builders Use of Water Patch.....		\$ 5-
Total \$		17.09

1935-153

Labor and Material Report

19

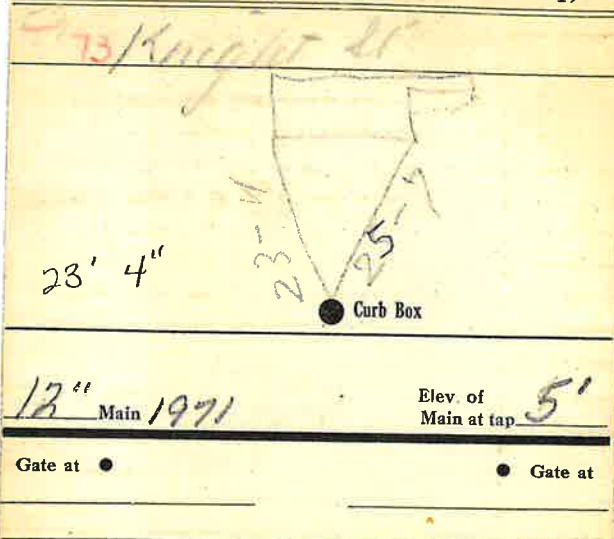

● Curb Box

old survey at
position