


Labor and Materials

1	Copper	Connection	3/4"	\$
1	Curb	Cock Valve	3/4" in ORISEAL	
		T. S. & V.		
1	Service Box	Short	3 1/2 x 4 1/2	
	Old returned	Long	4 1/2 x 5 1/2	
		Buff. or Rdway	4' to 5'	
11	3/4 in.	Copper	Pipe at	\$
		Galv Iron		
		Cast Iron		
	Nipples	in. at		\$
	Bushings	to in. at		\$
	Red's Inc's	Couplings to in. at		\$
	Union	in. at		\$
	Meter	in. at		\$
	Lead Joints	at		\$
	Leadite Joints	at		\$
	Hrs. Foreman	at		\$
	Hrs. Chauffeur	at		\$
	Hrs. Tapper	at		\$
	Hrs. Labor	at		\$
	Hrs. Labor	at		\$
	Hrs. Compressor	at		\$
	Compensation Ins.			\$
	Trucking			\$
	Builders Use of Water			\$
	TAP MADE	8-25-1971		\$
	BY	LARSEN & CO		\$
				\$
				\$

St.
 Ph.
 Ave. No. 75

Name of Owner
 Lamp

Labor and Mat'l. Report 8-25-1971

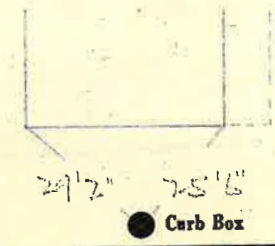

12" Main 1971 Elev. of Main at tap 51

Gate at • Gate at
 TAX ID # 309.15-2-5

● Curb Box