

Labor and Materials


	Copper	Connection	3/4			\$ 1.43		
	Lead							
	Curb	Cock Valve	3/4 in			\$ 1.88		
							T. S. & V.	
	Service Box	Short	3 1/2 x 4 1/2			\$ 1.75		
	Old returned	Long	4 1/2 x 5 1/2					
		Buff. or Rdway						
23	Ft. 3/4 in.	Copper Galv. Iron Cast Iron	}	Pipe at	18¢	\$ 4.68		
24								
	Nipples	in. at				\$		
	Bushings	to	in. at			\$		
	Red'g Inc'g	Conplings	to	in. at		\$		
	Union	in. at				\$		
	Meter	in. at				\$		
	Lead Joints	at				\$		
	Leadite Joints	at				\$		
1	Hrs. Foreman		3 1/4			\$ 3.1		
5	Hrs. Chauffeur		6 2 1/2			\$ 2.13		
8	Hrs. Tapper		5			\$ 5.00		
2	Hrs. Labor		45			\$ 3.60		
	Hrs. Labor					\$		
3	Hrs. Compressor		8 7 1/2			\$ 2.62		
	Compensation Ins.					\$ 37		
	Trucking					\$ 1.00		
	Builders Use of Water					\$		
	Sewer Tap also - Co. Rental					\$		
	Tap at 17th St					\$		
	Tap at 17th St by Pearson					\$		
						\$ 25.77		

2-1938

St.
Pt.
Ave. No. 78

Name of Owner
H. H. C.

Labor and Mat'l. Report Dec 17 19

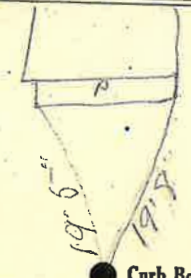

● Curb Box

12"-1971 8/24/71
Main

Elev. of
Main at tap

Gate at ●

● Gate at

TAX ID # 309.15-4-34

● Curb Box

old Street off at main

[Handwritten signature]

19' 5"

19' 8"