


LABOR AND MATERIALS

| | | | | |
|----|-------------------------|---------------------|---------|----|
| 1 | Copper | Connection | 3/4" | \$ |
| 1 | Lead | Cock | 3/4 in. | \$ |
| 1 | Curb | Valve | | \$ |
| | | T.S. & V. | | \$ |
| 1 | Service box | Short 3 1/2 x 4 1/2 | | \$ |
| | Old returned | Long 4 1/2 x 5 1/2 | | \$ |
| | | Buff or Rdway | | \$ |
| 29 | Ft. 3/4 in. | Copper | Pipe at | \$ |
| | | C.I. | | \$ |
| | | C.I. | | \$ |
| | Nipples | in. at | | \$ |
| | Bushings | to in. at | | \$ |
| | Red'g | | | \$ |
| | Inc'g | Coupl'gs. to in. at | | \$ |
| | Union | in. at | | \$ |
| | Meter | in. at | | \$ |
| | Lead Joints | at | | \$ |
| | Compound Joints | at | | \$ |
| | Maintenance Foreman | | | \$ |
| | Hrs. Water Maint. Man-1 | at | | \$ |
| | Hrs. Water Maint. Man-2 | at | | \$ |
| | Hrs. Garage Foreman | at | | \$ |
| | Hrs. Labor | at | | \$ |
| | Hrs. Compressor | at | | \$ |
| | Compensation Ins. at \$ | per C | | \$ |
| | Trucking | | | \$ |
| | Pav't Patch | | | \$ |
| | Tap by Gissord & Co | | | \$ |
| | 10-26-60 | | | \$ |
| | O'head | | | \$ |

St. Knight
 Pl. Ave. No. 86

Name of Owner De Marsh

Labor and Mat'l. Report Oct. 26 1960

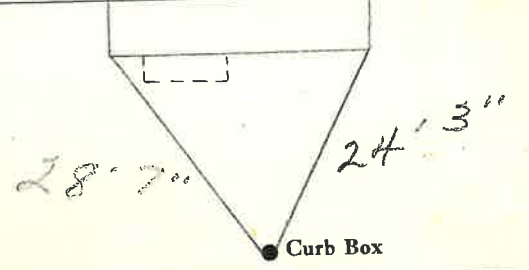

12" - 1971
 Main Elev. of Main at tap 5'

Gate at • Gate at •

• Curb Box