


**Labor and Materials**

1	Lead Connection		\$
	Curb Cock		\$
	Service Box (Short 3 1/2 x 4)	old box	\$
	Old returned (Buffalo)	return	\$
12	Ft. in. G. I. Pipe at		\$
	Nipples in. at		\$
	Bushings to in. at		\$
	Red'g Coup to in. at		\$
	Inc'g Coup to in. at		\$
	Union in. at		\$
	Meter in. at		\$
	Cu. Yds. Br. Stone at		\$
	Cu. Yds. Sand at		\$
	Bags Cement at		\$
	Paving Brick (Mack Red Asphalt) at		\$
2	Hrs. Foreman at		\$
4	Hrs. Common Labor at		\$
	Hrs. Mason at		\$
	Hrs. at		\$
	Hrs. at		\$
9.0	Builders' Use of Water		\$
	Trucks 100		\$
	at		\$
	at		\$
	at		\$
	at		\$
	Total	\$ 1,012.7	

June 25 1924  
 Labor and Material Report

8 Knight St.

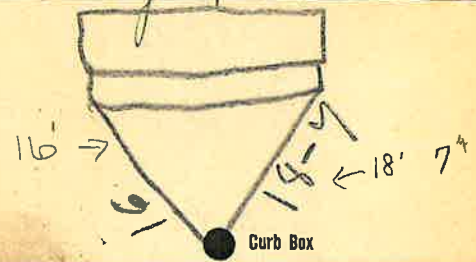

6 Main Elev. of Main at tap 4 1/2  
 Gate at ● Gate at ●

● Curb Box