


Labor and Materials

1	Lead Connection	\$
1	Curb Cock	\$
1	Service Box (Short 3" x 4") Old returned 4" x 6" Bustite	\$
30	Ft. 3 in. G. I. Pipe at	\$
	Nipples..... in. at	\$
	Bushings..... to..... in. at	\$
1	Red'g Coup. 3" to..... in. at <i>brass</i>	\$
	Inc'g Coup..... to..... in. at <i>1 in. reducing</i>	\$
	Union..... in. at <i>1 3/4 in. nipple</i>	\$
	Meter..... in. at	\$
	Cu. Yds. Br. Stone at	\$
	Cu. Yds. Sand at	\$
	Bags Cement at	\$
	Paving Brick { Mack Red Asphalt } at	\$
	Hrs. Foreman at	\$
17	Hrs. Common Labor at	\$
	Hrs. Mason at	\$
2	Hrs. <i>man</i> at	\$
	Hrs. at	\$
	Builders' Use of Water	\$
	<i>Truck</i> at	\$
 at	\$
 at	\$
	Total	\$	

July 1925
Labor and Material Report ~~52~~ 1925

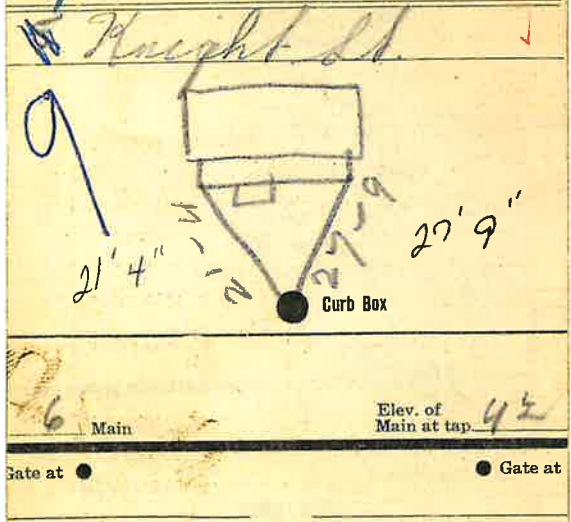

● Curb Box

9 Knight St.
S.A. Jarvis