


Labor and Materials

Lead Connection <sup>3/4</sup>	\$
1. Curb Cock <sup>3/4</sup>	\$
1. Service Box (Short 3 1/2 x 4 1/2) Old returned (Long 4 1/2 x 5 1/2) Butt	\$
9. Ft. <sup>3/4</sup> in. C. L. Pipe at	\$
1. Nipples <sup>1/2</sup> in. at (1 1/2" long)	\$
1. Bushings <sup>3/4</sup> to <sup>1/2</sup> in. at	\$
Red'g Coup... to... in. at	\$
Inc'g Coup... to... in. at	\$
Union... in. at	\$
Meter... in. at	\$
Cu. Yds. Br. Stone at	\$
Cu. Yds. Sand at	\$
Bags Cement at	\$
Paving Brick { Mack Red Asphalt } at	\$
<sup>24</sup> Hrs. Foreman at	\$
<sup>13</sup> Hrs. Common Labor at	\$
Hrs. Mason at	\$
<sup>1 1/2</sup> Hrs. <sup>Baker</sup> at	\$
Hrs. at	\$
<sup>70</sup> Builders' Use of Water	\$
at	\$
2 Elbows	\$
at	\$
at	\$
at	\$
Total	\$ 17.89

Labor and Material Report Aug. 1925

10 Knight St.

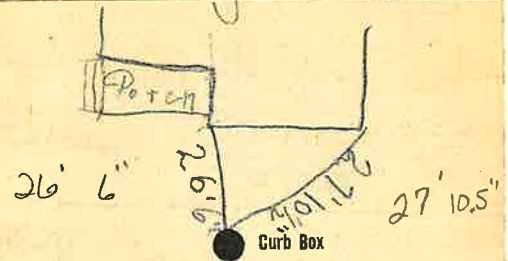

Main Elev. of  
Main at tap

Gate at ● ● Gate at

