


Labor and Materials

cap. Lead Connection	3/4	\$
1. Curb Cock	3/4	\$
1 Service Box (Short 3' x 4') Old returned		\$
56 3/4 in. Cast Pipe at	cap	\$
Nipples	in. at	\$
1. Bushing	3/4 to 1/2 in. at	\$
Red'g Coup	to in. at	\$
Inc'g Coup	to in. at	\$
Union	in. at	\$
Meter	in. at	\$
Cu. Yds. Br. Stone at		\$
Cu. Yds. Sand at		\$
Bags Cement at		\$
Paving Brick { Mack Red Asphalt } at		\$
23 1/4 Hrs. Foreman at		\$
15 1/2 Hrs. Common Labor at		\$
Hrs. Mason at		\$
1 Hrs. Baker		\$
Hrs.		\$
Builders' Use of Water		\$
Truck		\$
		\$
		\$
		\$
Total	20.14	\$

Labor and Material Report Aug. 19 26

11 * Knight St.

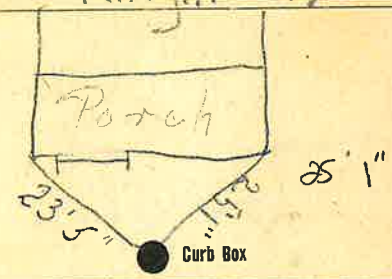

Main Elev. of Main at tap

Gate at ● ● Gate at

