


KNOX  
~~CROSSWAY~~

St.  
Pl.  
Ave. No. 2

Name of Owner

Labor and Mat'l. Report 19

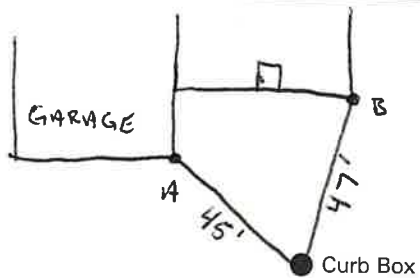

Main

Elev. of  
Main at tap

Gate at ●

● Gate at


● Curb Box

KNOX  
CROSSWAY

St.  
Pl.  
Ave. No. 2

Name of Owner

Labor and Mat'l. Report 19

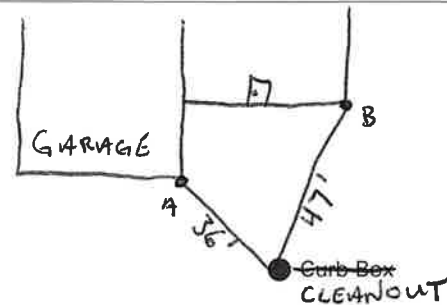

Main

Elev. of  
Main at tap

Gate at ●

● Gate at

● Curb Box

