

LABOR AND MATERIALS


Copper	Lead	Connection	3/4		
					\$ 2.87
	Curb	Cock Valve	3/4	in.	
		T-S & V.			
					\$ 3.62
	Service box	Short 3/4 X 4 1/2	} Same		
	Old returned	Long 4 1/2 X 5 1/2			
		Buff or Rdway			
	30 Ft.	3/4 in.	Copper	Pipe at	\$ 9.60
			G.I.		
			G.I.		
	Nipples	in.		at	\$
	Bushings	to		in. at	\$
	Red'g				\$
	Inc'g	Coupl'gs		to in. at	\$
	Union	in.		at	\$
	Meter	in.		at	\$
	Lead Joints	at			\$
	Compound Joints	at			\$
	Hrs. Water Maint. Man-1	at			\$
	8 Hrs. Water Maint. Man-2	at	1.02		\$ 8.16
	28 Hrs. Labor-	at	91		\$ 25.48
	Hrs. Labor-	at			\$
	Hrs. Compressor	at			\$
	Compensation Ins.	at \$ 2.18 per C			\$ 73
	Trucking				\$ 2.00
	Pav't Patch				\$
	Tap by M. J. Quinn				\$
	O'head				\$
					\$ 52.46

48

St. LaRose
 Pt.
 Ave. No. 46

Name of Owner Lambert

Labor and Mat'l. Report Apr 14 1948

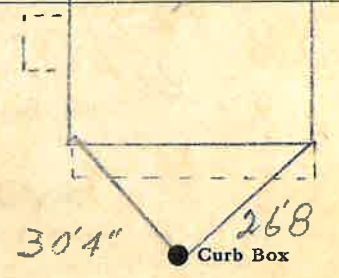

6 Main

Elev. of Main at tap 5

Gate at ● ● Gate at

● Curb Box

to be billed