

Labor and Materials


| | | | |
|-------|--|------|----------|
| 1 | Copper } Connection..... | 3/16 | \$ 1.33 |
| 1 | Lead } Connection..... | 3/16 | \$ 1.33 |
| 4 | Curb { Cock } | 3/8 | \$ 1.58 |
| | { Valve } | | |
| | { T.S.&V. } | | |
| 1 | Service Box { Short 3 1/2 x 4 1/2 } | | \$ 1.36 |
| | { Long 4 1/2 x 5 1/2 } | | |
| | { Built or Fitted } | | |
| 23 | Ft. } in. { Copper } Pipe at 19 1/2 | | \$ 2.18 |
| | { Galv. Iron } | | |
| | { Cast Iron } | | |
| | Nipples in. at | | \$ |
| | Bushings to in. at | | \$ |
| | Red'g } Couplings..... to in. at | | \$ |
| | Inc'g } | | |
| | Union..... in. at | | \$ |
| | Meter..... in. at | | \$ |
| | Lbs. Br. Stone at | | \$ |
| | Lbs. Sand at | | \$ |
| | Bags Cement at | | \$ |
| | Paving Brick { Mack } at | | \$ |
| | { Red } | | |
| | { Asphalt } | | |
| | Lead Joints at | | \$ |
| | Leadite Joints at | | \$ |
| 3 | Hrs. Foreman at | | \$ 1.86 |
| 7 | Hrs. Common Labor at | | \$ 3.50 |
| 7 | Hrs. Common Labor at | | \$ 3.15 |
| | Hrs. Mason at | | \$ |
| | Hrs. Masons Helper at | | \$ |
| | Hrs. Compressor at | | \$ |
| | Compensation Ins | 26 | \$ |
| | Trucking | 1 | \$ |
| | Builders Use of Water Patch | 2.50 | \$ 2.50 |
| Total | | | \$ 18.74 |

83-77 52

Labor and Material Report Oct 16 1933

27 LaRose St

21

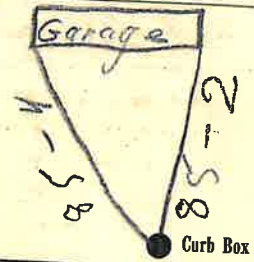

6 Main

Elev. of Main at tap 5

Gate at ●

● Gate at

● Curb Box

This is 21-NOV 52

(Signature)