

LABOR AND MATERIALS

Copper	} Connection	_____	\$ _____	
Lead				
Curb	} Cock	_____ in.	\$ _____	
				} Valve
Service box	} Short 3½ x 4½	_____	\$ _____	
Old returned				} Long 4½ x 5½
28 Ft. ¾ in.	} Pipe at	_____	\$ _____	
		} Copper		
		} G.I.		
Nipples	_____ in. at	\$ _____		
Bushings	_____ to _____ in. at	\$ _____		
Red'g	} Coupl'gs	_____ to _____ in. at	\$ _____	
Inc'g				
Union	_____ in. at	\$ _____		
Meter	_____ in. at	\$ _____		
Compound Joints	at	\$ _____		
Maintenance Foreman		\$ _____		
Hrs. Water Maint. Man-1	at	\$ _____		
Hrs. Water Maint. Man-2	at	\$ _____		
Hrs. Garage Foreman	at	\$ _____		
Hrs. Labor	at	\$ _____		
Hrs. Compressor	at	\$ _____		
Trucking		\$ _____		
Pav't Patch		\$ _____		
		\$ _____		
		\$ _____		

La Rose

St. Pt. Ave. No. 52½

Name of Owner

Labor and Mat'l. Report

19 88

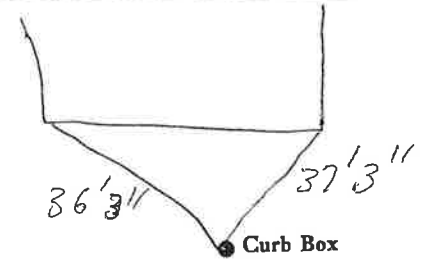

● Curb Box

Main

Elev. of Main at tap

Gate at ●

● Gate at

● Curb Box