

LABOR AND MATERIALS


Copper	Connection	3/4		\$ 2.87
Lead				
Curb	Cock Valve	3/4	in.	\$ 3.62
	T. S. & V.			
Service box	Short 3 1/2 X 4 1/2			
Old returned	Long 4 1/2 X 5 1/2			
	Buff or Rdway			\$ Same
11 Ft.	3/4 in.		Pipe at	37 \$ 3.52
Nipples	in. at			\$
Bushings	to in. at			\$
Red'g				
Inc'g	Coupl'gs. to in. at			\$
Union	in. at			\$
Meter	in. at			\$
Lead Joints	at			\$
Compound Joints	at			\$
Hrs. Water Maint. Man—1	at			\$
3	Hrs. Water Maint. Man—2	at	1.02	\$ 3.06
1.4	Hrs. Labor—	at	.91	\$ 12.74
Hrs. Labor—	at			\$
Hrs. Compressor at				\$
Compensation Ins. at	\$ 2.18	per C		\$ 3.4
Trucking				\$ 2.02
Pav't Patch				\$
Supply				\$
O'head				\$
				\$ 28.15

49

St. _____
 Pl. _____
 Ave. No. 55

Name of Owner _____
Finnson

Labor and Mat'l. Report April 12 1947

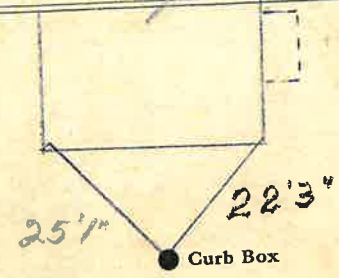

6" Main Elev. of Main at tap 5'

Gate at ● ● Gate at

● Curb Box

LSM-5C 5 18-48

To be Billed