


LABOR AND MATERIALS

1	Copper <del>Lead</del>	} Connection	3/4"	}	\$
1	Curb				
1	Service box Old returned	} Short 3 1/2 x 4 1/2 Long 4 1/2 x 5 1/2 Buff or Rdway	}	\$	
27	Ft. 3/4 in.				Copper <del>C.P.</del>
	Nipples	in. at	\$		
	Bushings	to in. at	\$		
	Red'g Inc'g	} Coupl'gs	to in. at	\$	
	Union				in. at
	Meter	in. at	\$		
	Lead Joints at		\$		
	Compound Joints at		\$		
	Maintenance Foreman		\$		
	Hrs. Water Maint. Man-1 at		\$		
	Hrs. Water Maint. Man-2 at		\$		
	Hrs. Garage Foreman at		\$		
	Hrs. Labor— at		\$		
	Hrs. Compressor at		\$		
	Compensation Ins. at \$	per C	\$		
	Trucking		\$		
	Pav't Patch		\$		
			\$		
			\$		
	O'head	AUG 3-1972	\$		
			\$		

Tap made by LARSON

LA Rose St. No. 56  
 Name of Owner Dorothy Meehan  
 Labor and Mat'l. Report AUG 3 1972

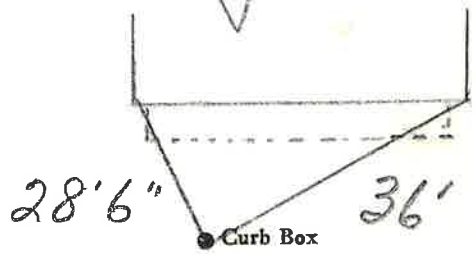

6" Main Elev. of Main at tap 3'  
 Gate at • Gate at •  
 • Curb Box