


Labor and Materials

Copper	} Connection		\$	
Lead				
Carb	} Cock Valve T. S. & V. in	\$	
Service Box		} Short 3 1/2 x 4 1/2 Long 4 1/2 x 5 1/2 Buff. or Rdway		\$
Old returned				
Ft. in.	} Copper Galv Iron Cast Iron	Pipe at	\$	
Nipples		in. at	\$	
Bushings		to in. at	\$	
Red'g	} Conplings to in. at	\$	
Inc'g				
Union	in. at		\$	
Meter	in. at		\$	
Lead Joints	at		\$	
Leadite Joints	at		\$	
Hrs. Foreman	at		\$	
Hrs. Chauffeur	at		\$	
Hrs. Tapper	at		\$	
Hrs. Labor	at		\$	
Hrs. Labor	at		\$	
Hrs. Compressor	at		\$	
Compensation Ins.			\$	
Trucking			\$	
Builders Use of Water			\$	
			\$	
			\$	
St. 16
Pl. 61
Ave. No. 61

Name of Owner
Scotfield

Labor and Mat'l. Report 11-8-22 19

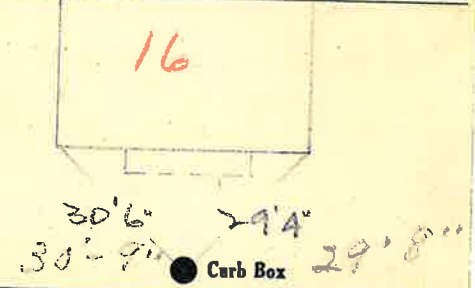

.....Main Elev. of Main at tap.....

Gate at ● ● Gate at

● Curb Box