

Labor and Materials


Copper	} Connection	\$
Lead		\$
Curb	} Cock Valve T. S. & V. in	\$
Service Box		} Short 3½ x 4½ Long 4½ x 5½ Buff. or Rdway
Old returned		
Ft. in.	} Copper Galv Iron Cast Iron	Pipe at	\$
Nipples		in. at	\$
Bushings		to	in. at
Red'g Inc'g	} Conplings to	in. at
Union		in. at	\$
Meter	in. at	\$	
Lead Joints at	\$		
Leadite Joints at	\$		
Hrs. Foreman at	\$		
Hrs. Chauffeur at	\$		
Hrs. Tapper at	\$		
Hrs. Labor at	\$		
Hrs. Labor at	\$		
Hrs. Compressor at	\$		
Compensation Ins.	\$		
Trucking	\$		
Builders Use of Water	\$		
.....	\$		
.....	\$		
.....	\$		
.....	\$		

St. 18
Pt.
Ave. No. 59

LaRoc

Name of Owner
Hammond

Labor and Mat'l. Report 19

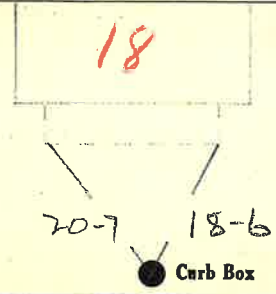

..... Main Elev. of
Main at tap.....

Gate at ● ● Gate at

● Curb Box