


LABOR AND MATERIALS

1	Copper	} Connection	3/4"	\$
1	Lead			
1	Curb	} Cock Valve T.S. & V.	3/4 in. MARK II OT/SEAL	\$
1	Service box			
	Old returned	} Short 3 1/2 x 4 1/2 Long 4 1/2 x 5 1/2 Buff or Rdway		\$
26	3/4 in.			
	Nipples	in. at	\$	
	Bushings	to in. at	\$	
	Red'g } Inc'g }	Coupl'gs	to in. at	\$
	Union	in. at	\$	
	Meter	in. at	\$	
	Lead Joints	at	\$	
	Compound Joints	at	\$	
	Maintenance Foreman		\$	
	Hrs. Water Maint. Man—1	at	\$	
	Hrs. Water Maint. Man—2	at	\$	
	Hrs. Garage Foreman	at	\$	
	Hrs. Labor—	at	\$	
	Hrs. Compressor at		\$	
	Compensation Ins. at \$	per C	\$	
	Trucking		\$	
	Pav't Patch		\$	
	Tap By Beecher & Co		\$	
	Aug-9-1974		\$	
	O'head		\$	

LA Rose St. Pl. Ave. No. 20


Name of Owner Leslie Wood

Labor and Mat'l. Report Aug 9 1974

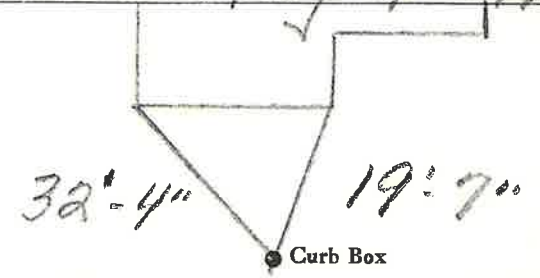

6" Main Elev. of Main at tap 4 1/2'

Gate at • Gate at

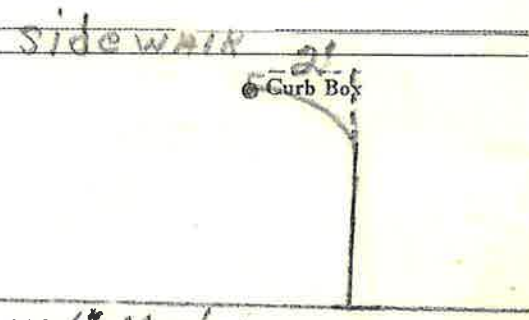

LSM-SC-6-1-67 6" MAIN