

LABOR AND MATERIALS

1	Copper Lead	Connection	3/4	\$	2.94
1	Curb	Cock Valve T. S. & V.	3/4 in.	\$	3.71
1	Service box	Short 3 1/2 X 4 1/2			
	Old returned	Long 4 1/2 X 5 1/2			5.90
		Buff or Rdway			
28	Ft.	Copper G.I. C.I.	in. Pipe at	30	\$ 8.40
	Nipples	in. at		\$	
	Bushings	to in. at		\$	
	Red'g				
	Inc'g	Coupl'gs to in. at		\$	
	Union	in. at		\$	
	Meter	in. at		\$	
	Lead Joints at			\$	
	Compound Joints at			\$	
	Hrs. Water Maint. Man	-1 at		\$	
5	Hrs. Water Maint. Man	-2 at	1.02	\$	5.10
36	Hrs. Labor	at	91	\$	33.26
	Hrs. Labor	at		\$	
	Hrs. Compressor at			\$	
	Compensation Ins. at \$	per C		\$.84
	Trucking			\$	1.00
	Pay't Patch	Before Paving		\$	
	Tap by Mfg. Co.			\$	
	O'head			\$	
				\$	6.05

132

St.
~~Pl.~~
 Ave. No. 32


LaRose

Name of Owner

Lynch

Labor and Mat'l. Report

Sept 16 1948

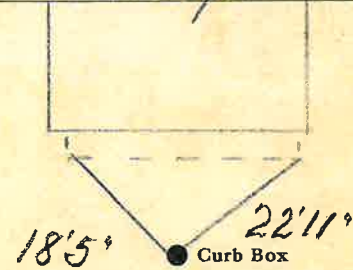

6 Main Elev. of Main at tap 4
 Gate at ● Gate at ●

● Curb Box

To be Billed