

Labor and Materials

1	Copper } Connection $3/4"$	\$ 1.25
	Lead }	
1	Curb { Cock Valve T.S.&V. } $3/4"$ in	\$ 1.70
1	Service Box { Short $3\frac{1}{2} \times 4\frac{1}{2}$ Long $4\frac{1}{2} \times 5\frac{1}{2}$ Old returned Buff. or Rdway }	\$ 1.37
10	Ft. in. { Copper Galv. Iron Cast Iron } Pipe at $12\frac{1}{2}$	\$ 1.25
	Nipples in. at	\$
1	Bushings $3/4"$ to $1\frac{1}{2}"$ in. at	\$.65
	Red'g } Couplings to in. at	\$
	Inc'g }	
	Union in. at	\$
	Meter in. at	\$
	Lbs. Br. Stone at	\$
	Lbs. Sand at	\$
	Bags Cement at	\$
	Paving Brick { Mack Red Asphalt } at	\$
	Lead Joints at	\$
	Leadite Joints at	\$
7	Hrs. Foreman at $6\frac{1}{2}$	\$ 1.75
1	Hrs. Common Labor at	\$.50
6	Hrs. Common Labor at $4\frac{1}{2}$	\$ 2.92
	Hrs. Mason at	\$
	Hrs. Masons Helper at	\$
	Hrs. Compressor at	\$
	Compensation Ins	\$ 12
	Trucking	\$ 1.
	Builders Use of Water	\$
Total		\$ 11.58


1935-148

Labor and Material Report

Aug 24

1935

$3/4"$ Tap at 36 to Base 34
on Montcalm St.

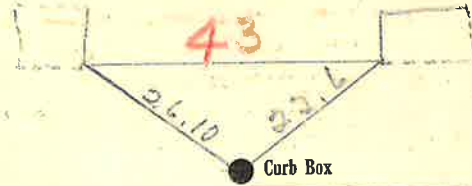

6" Main

Elev. of Main at tap 5

Gate at ●

● Gate at

● Curb Box

old shut off at main

This Tap on Montcalm St.