


**Labor and Materials**

1	Copper	1	Connection	\$ 2.60
1	Lead	1	Connection	\$ 2.21
1	Curb	1	Cock Valve	\$ 2.21
			to S. & V.	
1	Service Box	1	Short 3 1/2 x 4 1/2	\$ 1.39
	Old returned	1	Long 4 1/2 x 5 1/2	
			Buff or Rdway	
10	Ft.	10	Copper	\$ 1.50
	in.		Cast Iron	
			Pipe at	
	Nipples		in. at	\$
	Bushings		to in. at	\$
	Red'g Inc'g		Couplings to in. at	\$
	Union		in. at	\$
	Meter		in. at	\$
	Lbs. Br. Stone		at	\$
	Lbs. Sand		at	\$
	Bags Cement		at	\$
	Paving Brick		Mack Red Asphalt at	\$
	Lead Joints		at	\$
	Leadite Joints		at	\$
7	Hrs. Foreman	6 1/2		\$ 1.25
4	Hrs. Common Labor	40		\$ 1.60
	Hrs. Common Labor			\$
	Hrs. Mason			\$
	Hrs. Mason's Helper			\$
	Hrs. Compressor			\$
	Compensation Ins			\$ .09
	Trucking			\$ 1.00
	Builders Use of Water	Patch (Ext.)		\$
Total \$				11.99

32-10  
**Labor and Material Report** *Mar* 19 1932

*Top Lake Ave No 20*

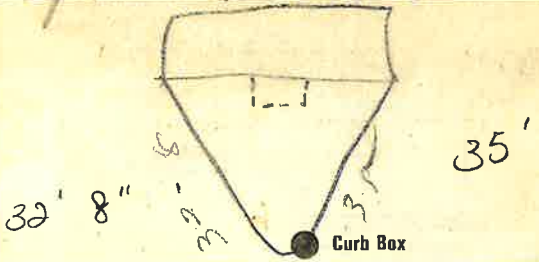

6 Main  
 Eley of Main at tap 4  
 Gate at ● Gate at ●

● Curb Box

*Man House*