


LABOR AND MATERIALS

Copper	}	Connection		\$	
Lead					
Curb	}	Cock	in.	\$	
		Valve			
		T. S. & V.			
Service box	}	Short $3\frac{1}{2} \times 4\frac{1}{2}$		\$	
Old returned		Long $4\frac{1}{2} \times 5\frac{1}{2}$			
11 Ft. $3\frac{1}{4}$ in.	}	Copper	} Pipe at	\$	
		C.I.			
		C.I.			
Nipples	in. at			\$	
Bushings	to in. at			\$	
Red'g	}	Coupl'gs	to in. at	\$	
Inc'g					
Union	in. at			\$	
Meter	in. at			\$	
Compound Joints	at			\$	
Maintenance Foreman				\$	
Hrs. Water Maint. Man	—1 at			\$	
Hrs. Water Maint. Man	—2 at			\$	
Hrs. Garage Foreman	at			\$	
Hrs. Labor	at			\$	
Hrs. Compressor	at			\$	
Trucking				\$	
Pav't Patch				\$	
				\$	
				\$	
				\$	
				\$	

St.
Pr.
Ave. No. 22

Name of Owner
R. Anderson

Labor and Mat'l. Report Oct 1987

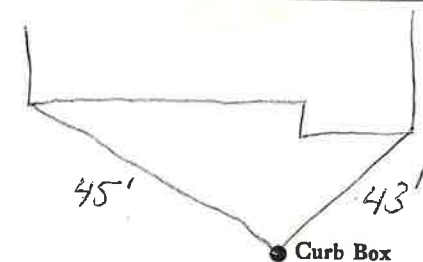

Main	Elev. of Main at tap
Gate at ●	● Gate at

● Curb Box