

LABOR AND MATERIALS

1. Copper { Connection $3/4"$ \$ 2.76
 Lead }
 1. Curb { Cock } $3/4"$ in. \$ 3.49
 Valve }
 T. S. & V. }
 1. Service box { Short $3 1/2 \times 4 1/2$ }
 Old returned { Long $4 1/2 \times 5 1/2$ } \$ 4.74
 { Buff. or Rdway }
 9 Ft. $3/4$ in. { Copper } Pipe at 35 \$ 3.15
 { G.I. }
 { G.I. }
 Nipples in. at \$
 Bushings to in. at \$
 Red'g (..... \$
 Inc'g { Coupl'gs to in. at \$
 Union in. at \$
 Meter in. at \$
 Lead Joints at \$
 Compound Joints at \$
 3 Hrs. Water Maint. Man-1 at 1.34 \$ 4.02
 Hrs. Water Maint. Man-2 at \$
 Hrs. Labor- at \$
 Hrs. Labor- at \$
 Hrs. Compressor at \$
 Compensation Ins. at \$ 4.40 per C \$ 18
 Trucking \$ 1.00
 Pav't Patch \$
 Tap. by WARSINSKI \$
 12-17-52 \$
 O'head \$
 \$19.34


1952
136

St. Lake

Pi.
Ave. No. 26

Name of Owner
Koppel

Labor and Mat'l. Report Dec. 17 1952

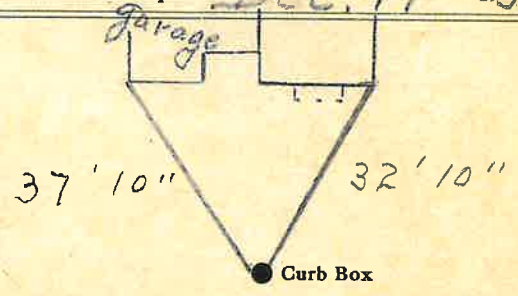

6" Main Elev. of Main at tap $4 1/2$

Gate at ● Gate at ●

● Curb Box